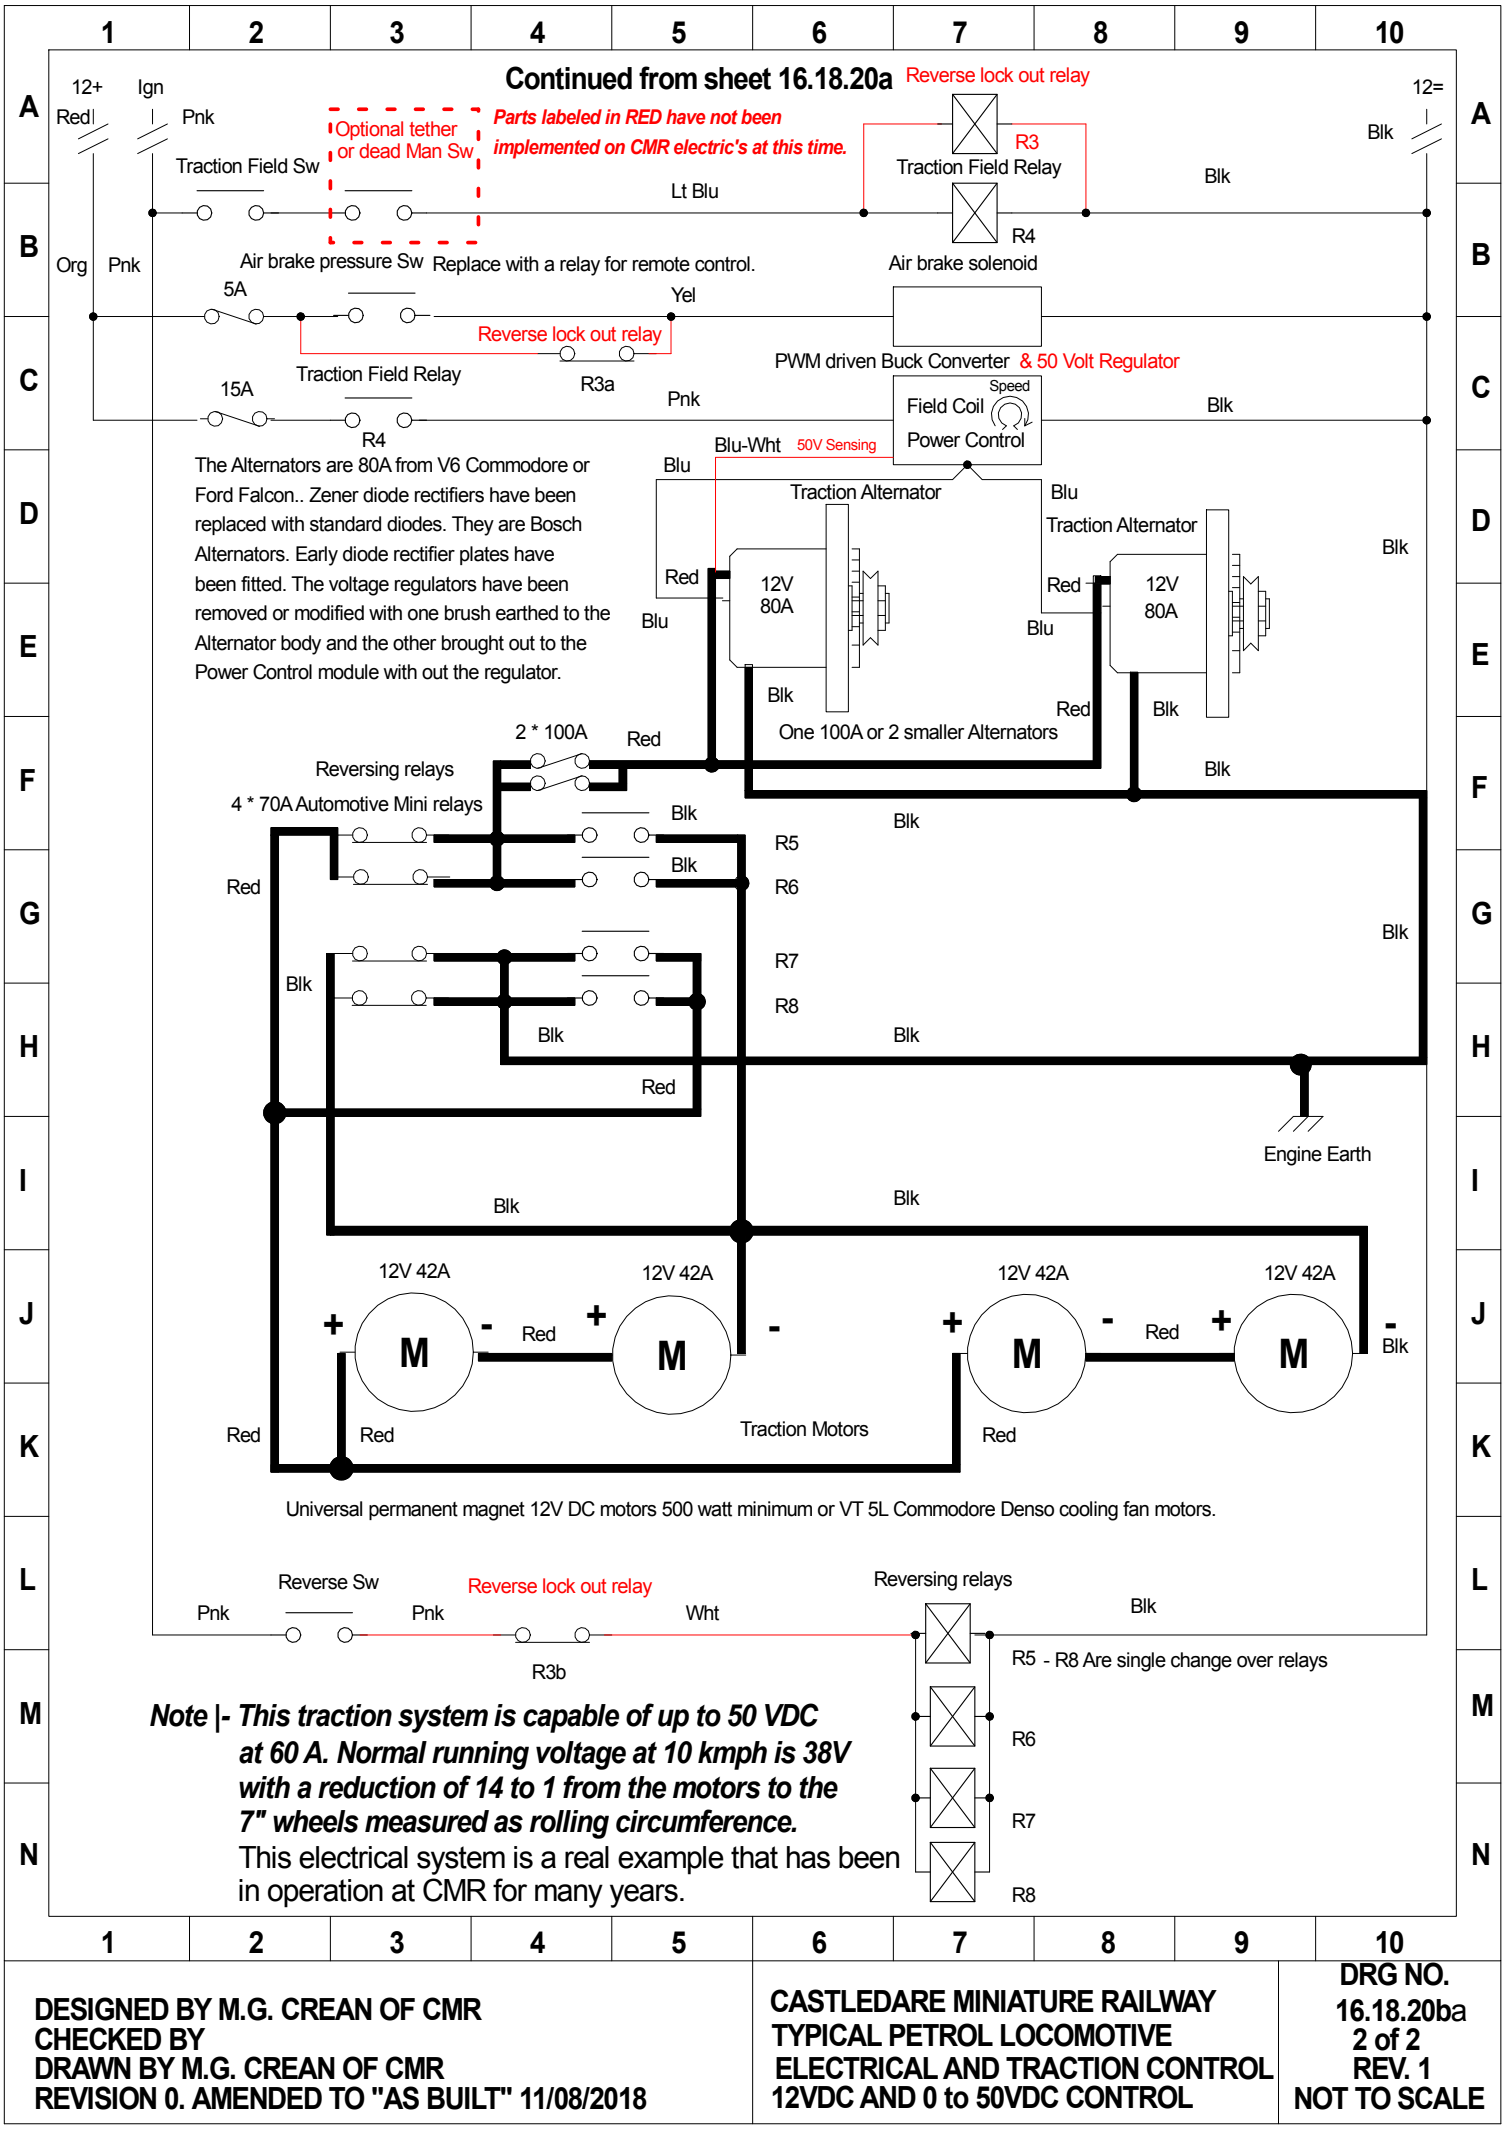

DESIGNED BY M.G. CREAN OF CMR CHECKED BY DRAWN BY M.G. CREAN OF CMR REVISION 0. AMENDED TO "AS BUILT" 11/08/2018	CASTLEDARE MINIATURE RAILWAY TYPICAL PETROL LOCOMOTIVE ELECTRICAL AND TRACTION CONTROL 12VDC AND 0 to 50VDC CONTROL	DRG NO. 16.18.20ba 2 of 2 REV. 1 NOT TO SCALE